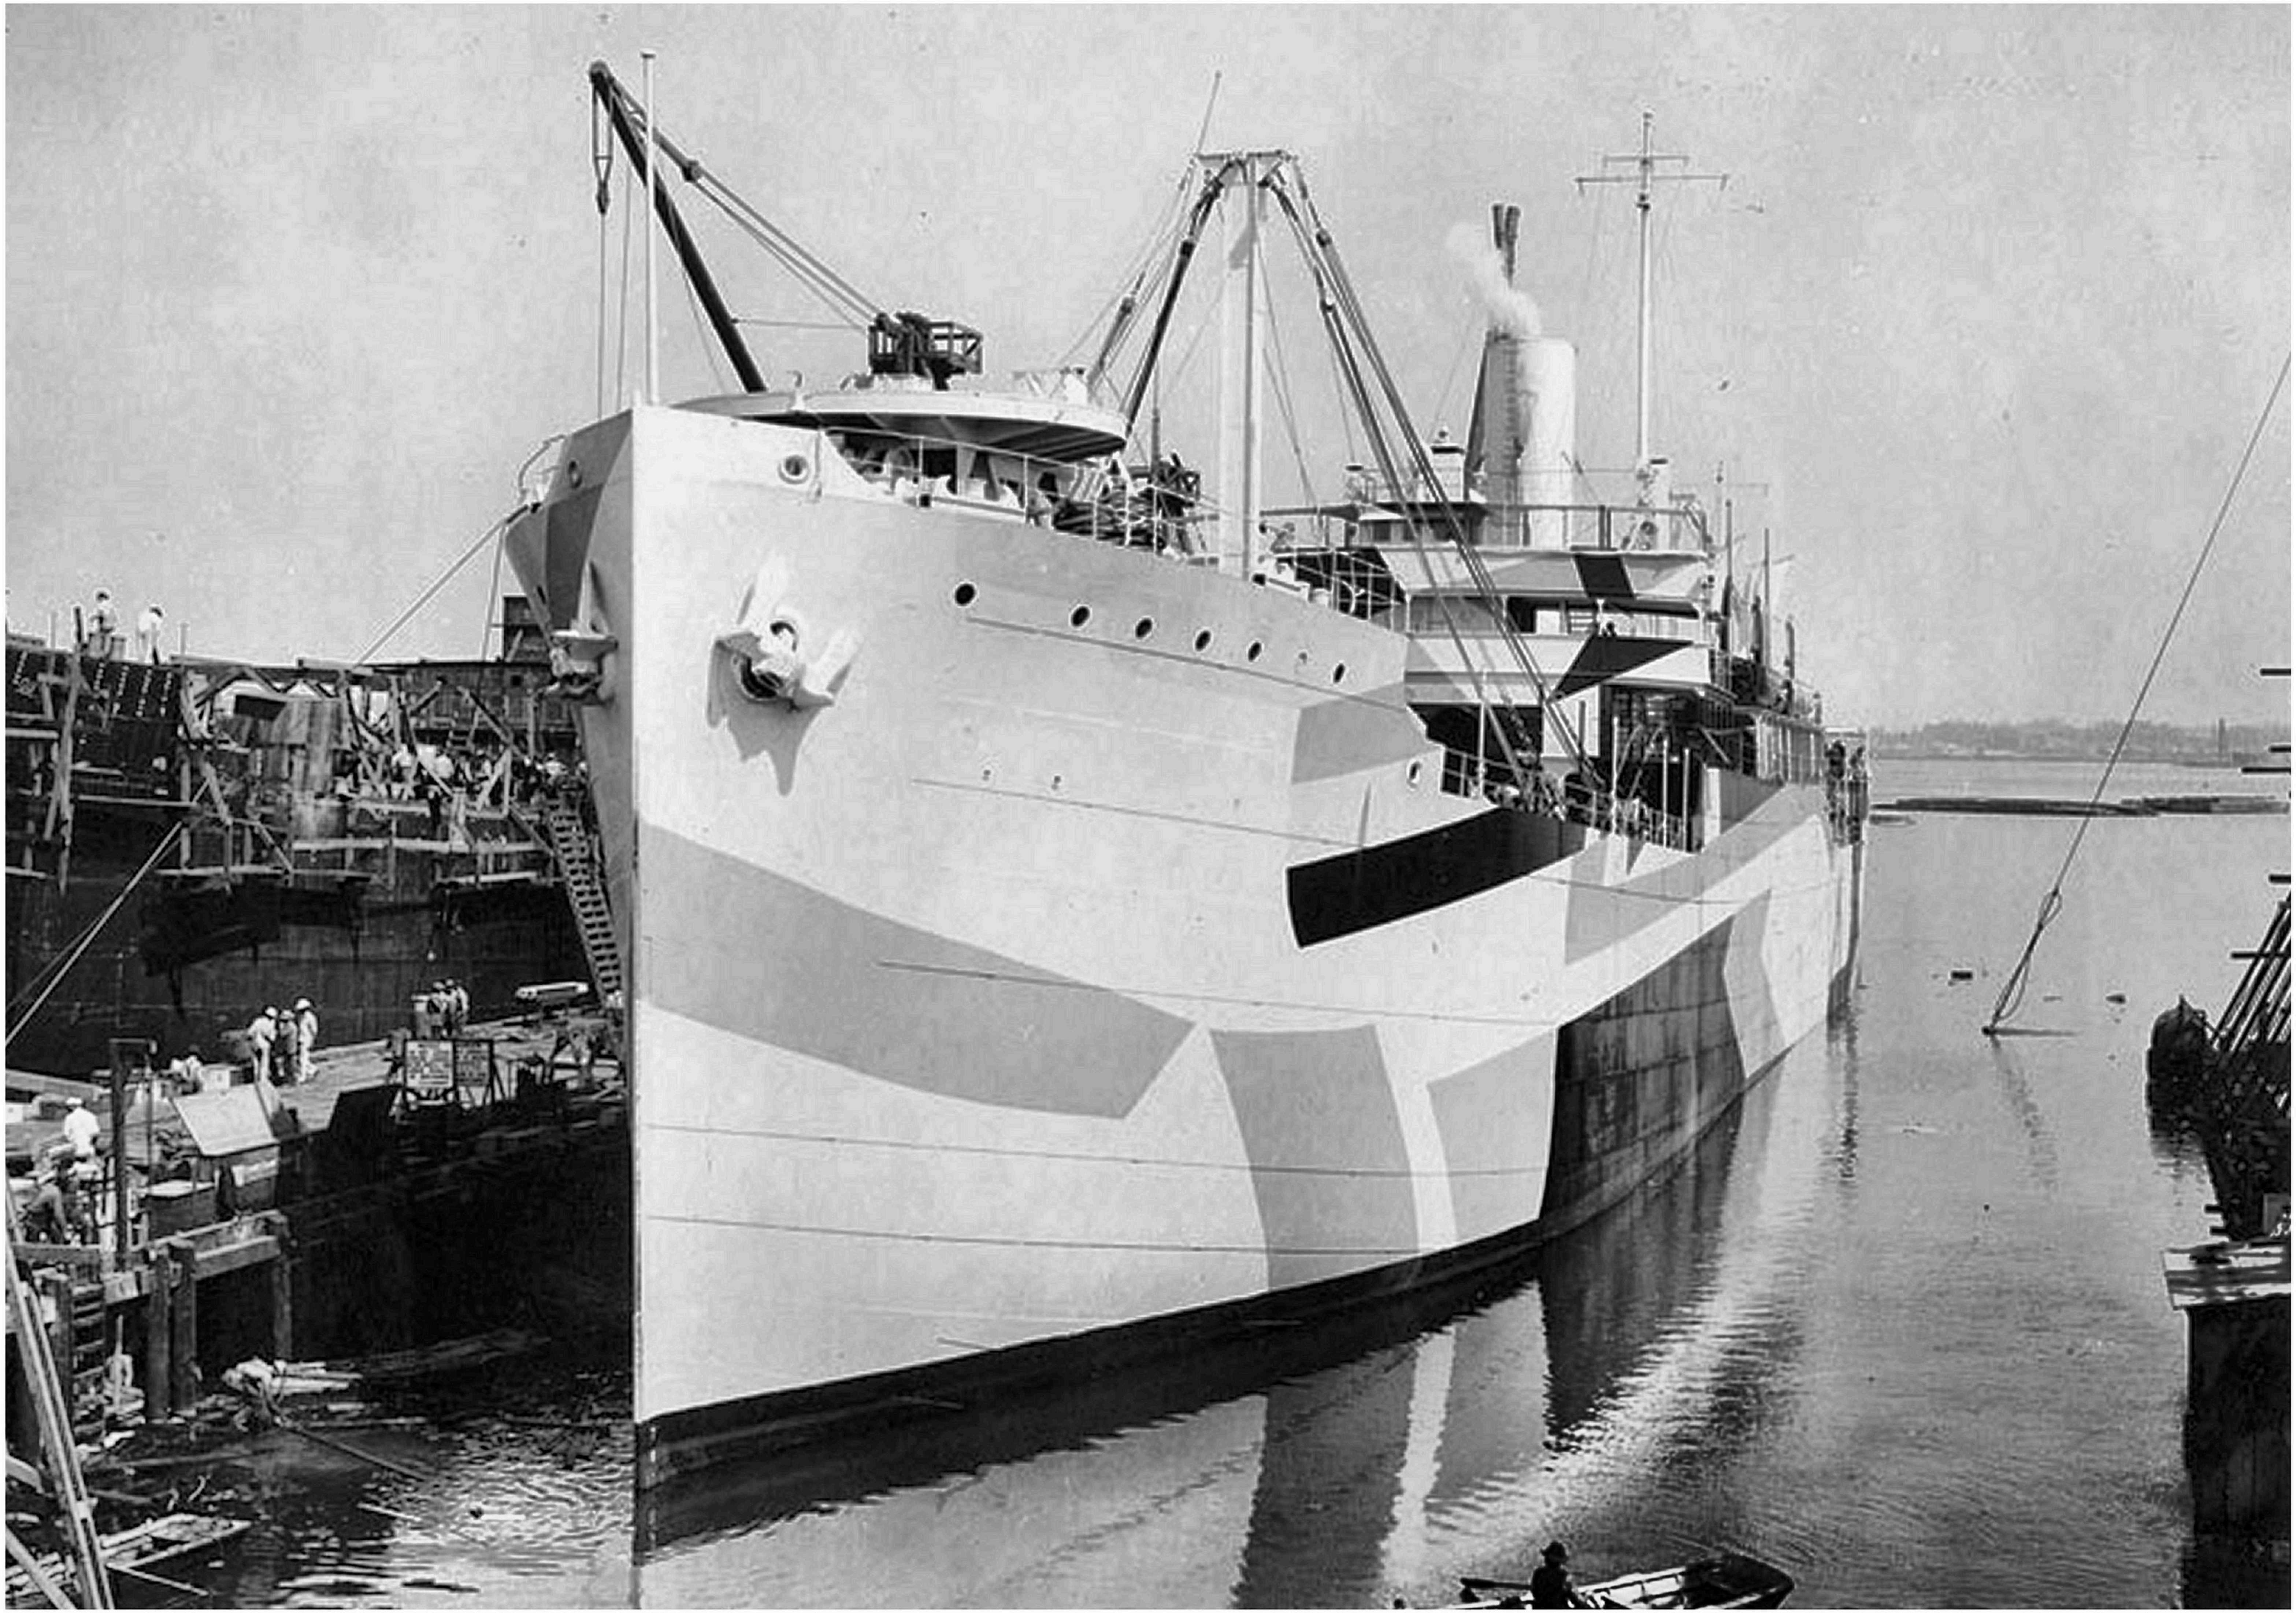

00 - cover photo

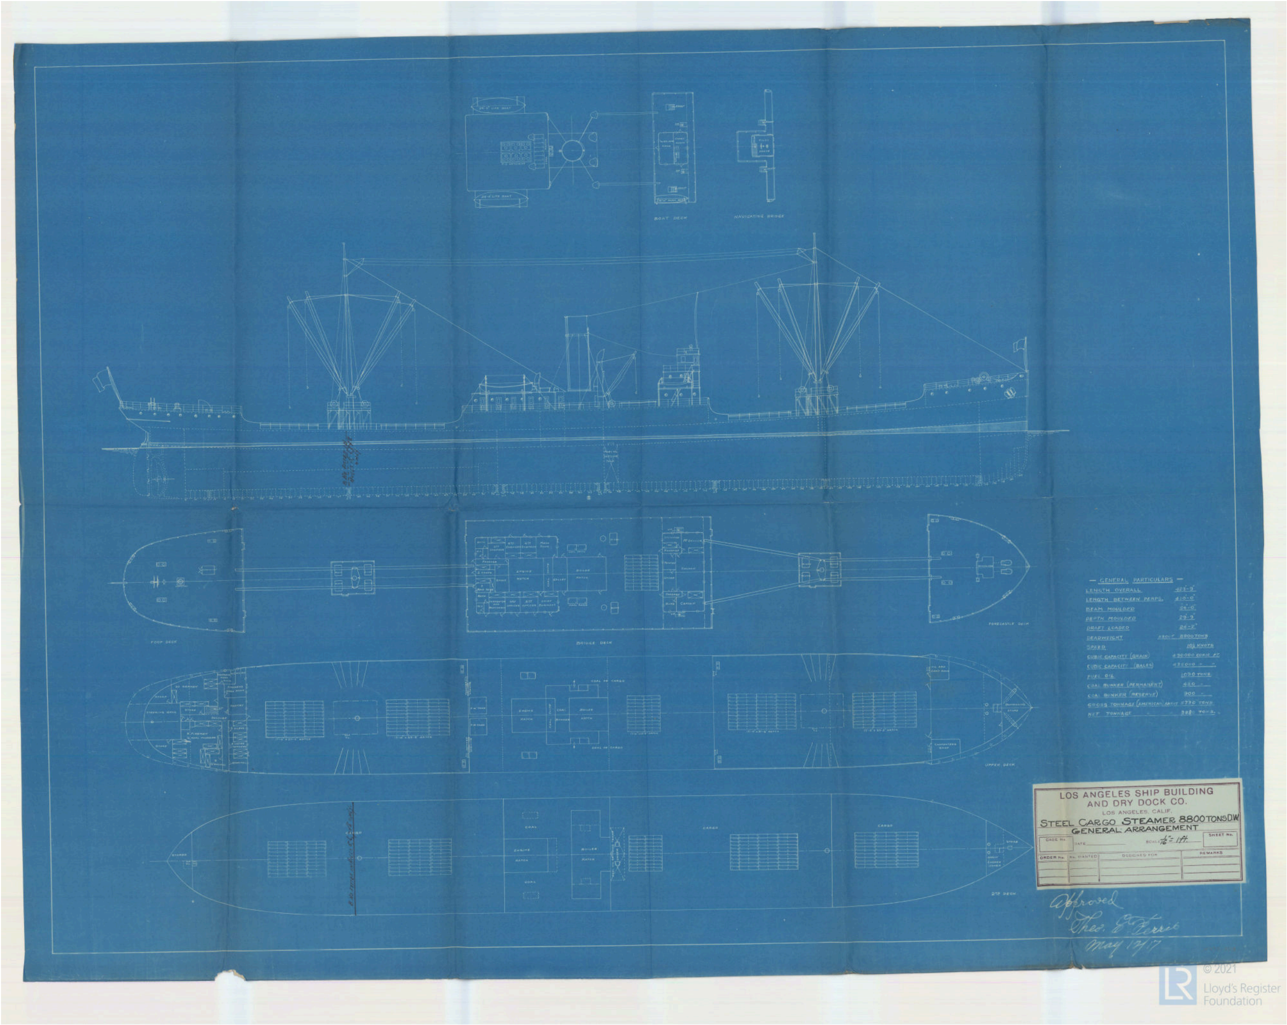
LOS ANGELES SHIP BUILDING
AND DRY DOCK CO.
LOS ANGELES, CALIF.
STEEL CARGO STEAMER 8800 TONS D.W.
GENERAL ARRANGEMENT
SCALE 1/16" = 1 ft.
Approved
Thos. E. Ferris
May 17/17
© 2021
Lloyd's Register Foundation

01 - general arrangement

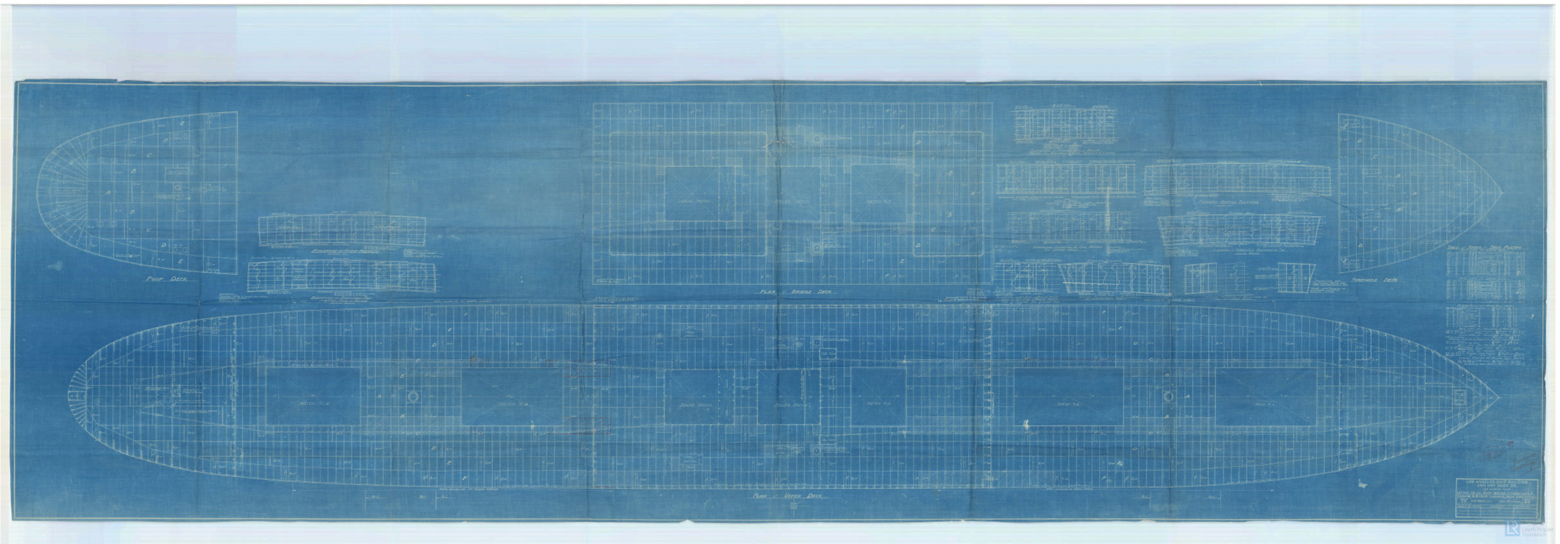

02 - upper deck & above, various casings

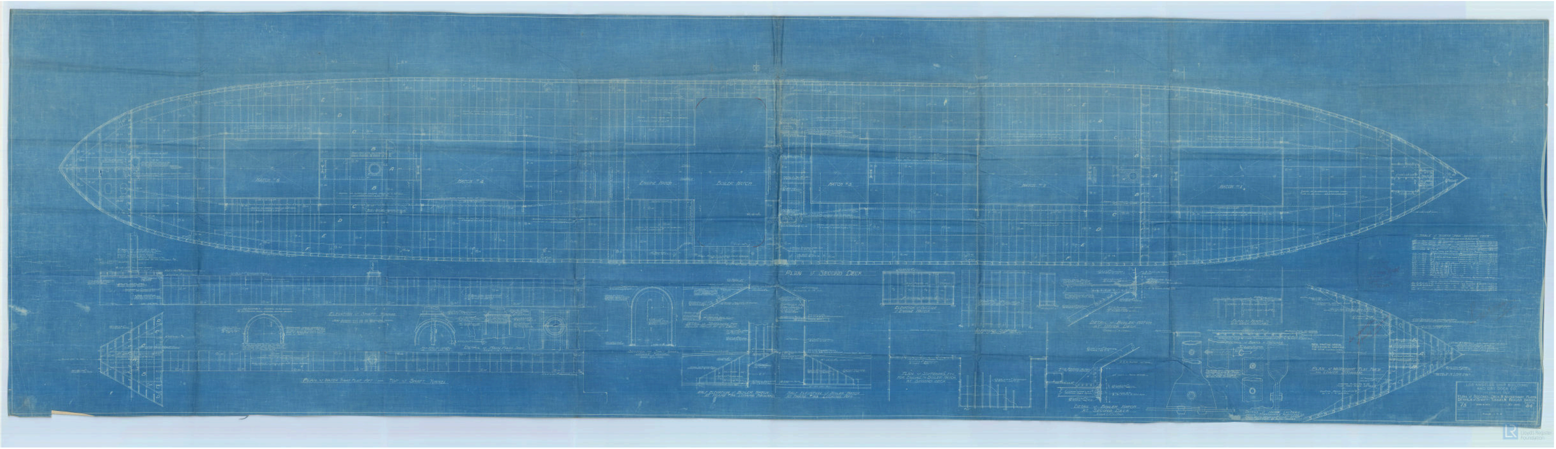

03 - second deck, various details

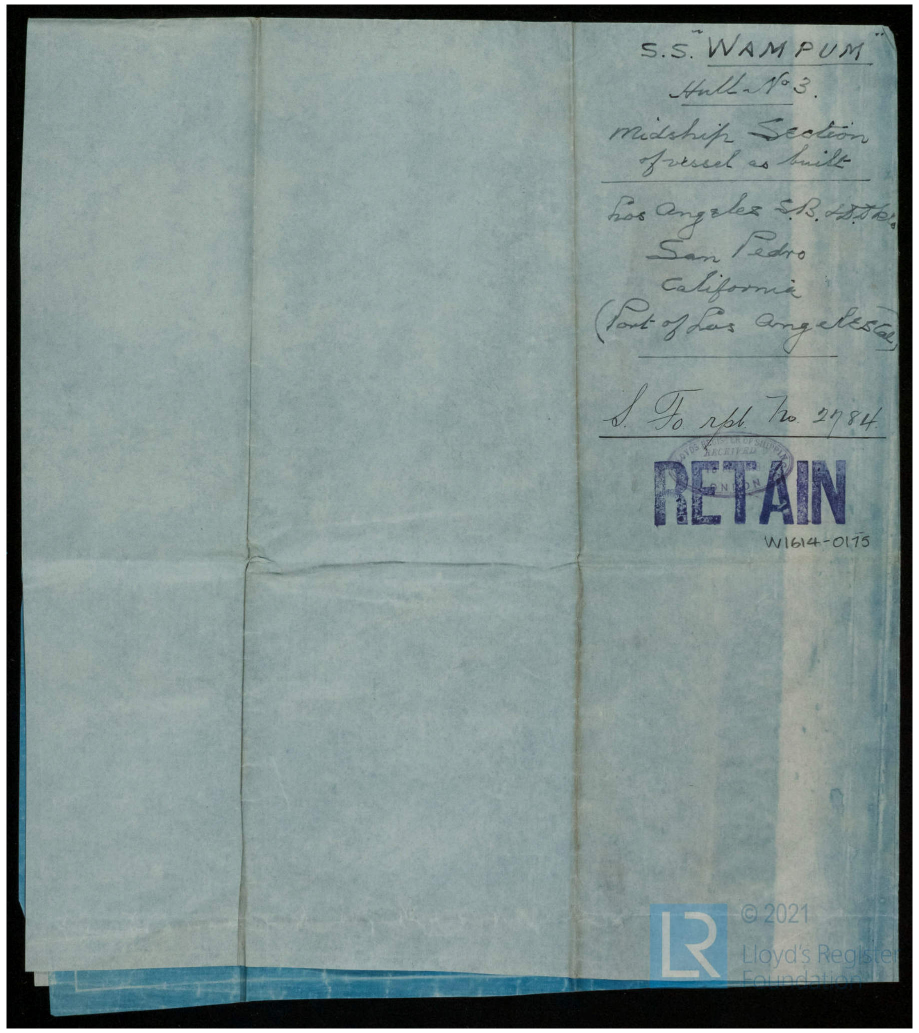

S.S. "WAMPUM"
Hull-No 3.
midship Section
of vessel as built

Los Angeles S.B. & D.D. Co.
San Pedro
California
(Port of Los Angeles Cal)

S. Fo. rpt. No. 2784

LLOYDS REGISTER OF SHIPPING RECEIVED LONDON

RETAIN

W1614-0175

© 2021 Lloyd's Register Foundation

04 - cover sheet half midship section 1

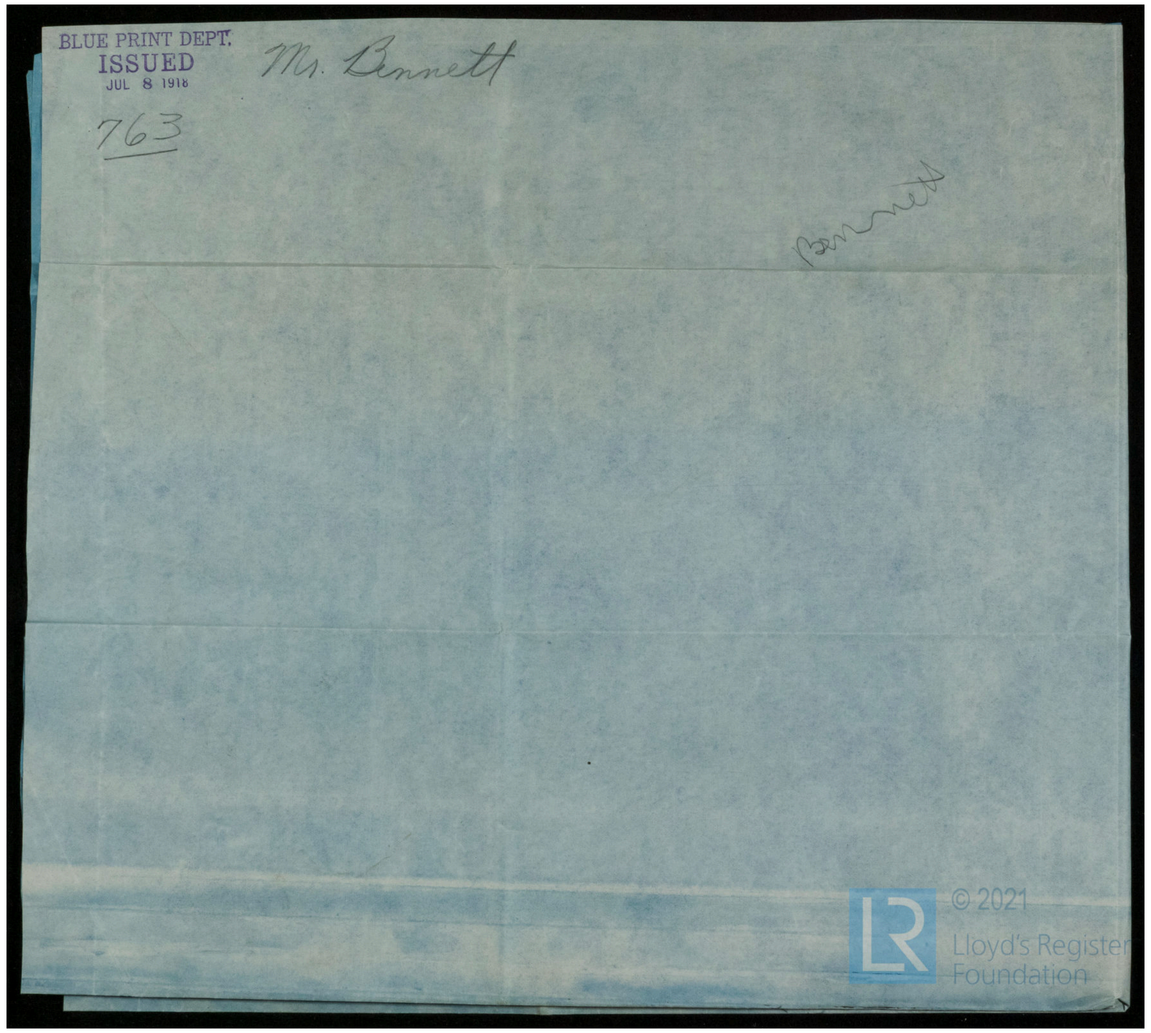

BLUE PRINT DEPT.
ISSUED
JUL 8 1918

Mr. Bennett

763

Bennett

© 2021 Lloyd's Register Foundation

05 - cover sheet half midship section 2

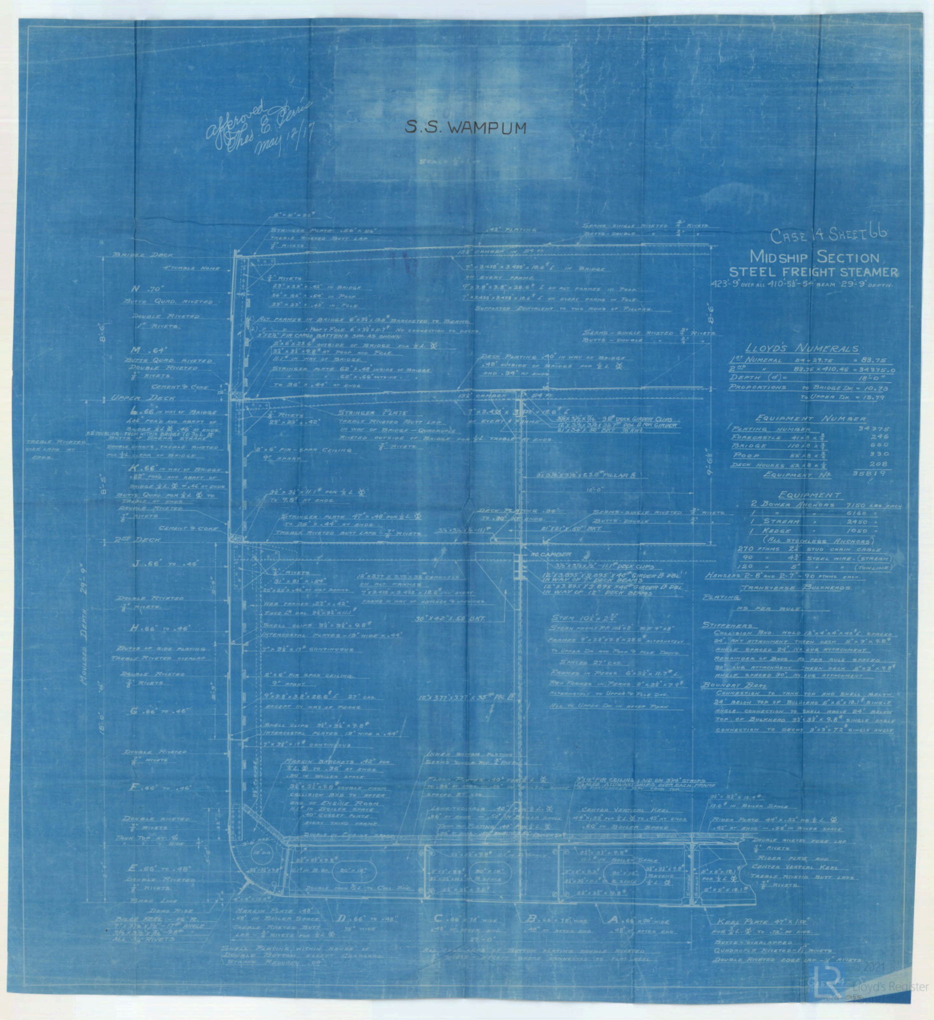
S.S. WAMPUM
Case 14 Sheet 66
MIDSHIP SECTION
STEEL FREIGHT STEAMER
423'-9" over all 410'-5½"-54' beam 29'-9" depth.
LLOYD'S NUMERALS
1st Numeral 54 + 29.75 = 83.75
2nd " 83.75 x 410.45 = 34375.0
Depth (d) = 18'-0"
Proportions to Bridge Dk = 10.73
to Upper Dk. = 13.79
8'-6"
Equipment Number
Equipment

06 - half midship section

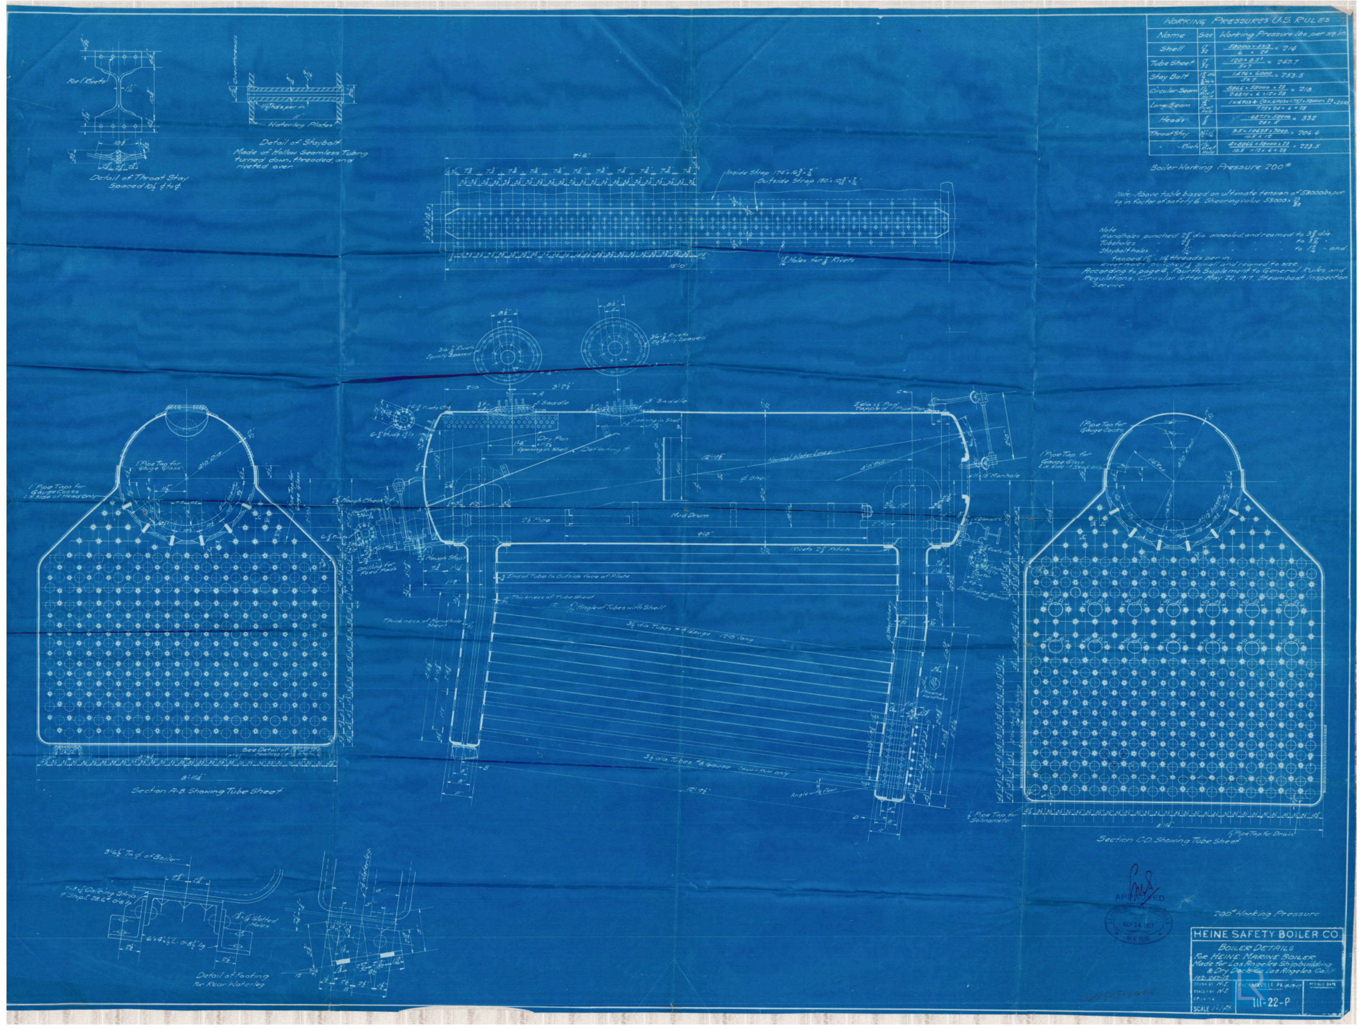
Section C.D. Showing Tube Sheet
1½ Pipe Tap for Drain
APPROVED
SEP 14 1917
NEW YORK
200# Working Pressure
HEINE SAFETY BOILER CO.
BOILER DETAILS
For HEINE MARINE BOILER
Made for Los Angeles Shipbuilding
& Dry Dock Co Los Angeles Calif.
102-247-15
DRAWN BY N.E.
TRACED BY N.E.
PHOENIXVILLE PA 9-13-17
REVISED DATE
SCALE 1"=1 ft.
III-22-P

07 - marine boiler